





-26-93

Hillier, Warner



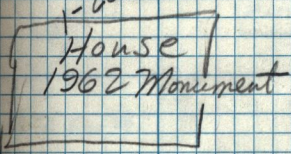


T.6 N.
R.2 W.


p.p.
Q 59.49'

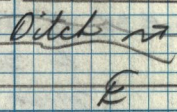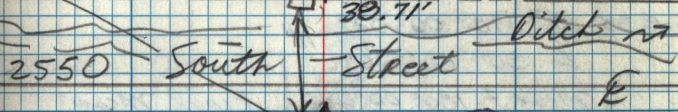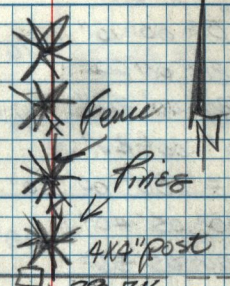

27
34

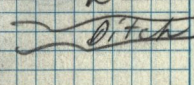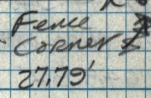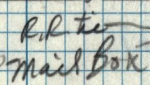

1962 Mon.

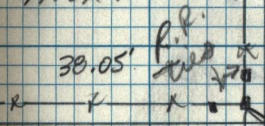

Corner


Small 1-26-94 ditch
H. & W.

Fence Corner 46.08'

2550 So. St.

27.75' p.p.

2700 W. St.

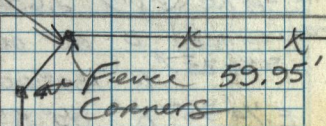

27	26
34	35