


21/28



Weber County
1963

2/13/85

12

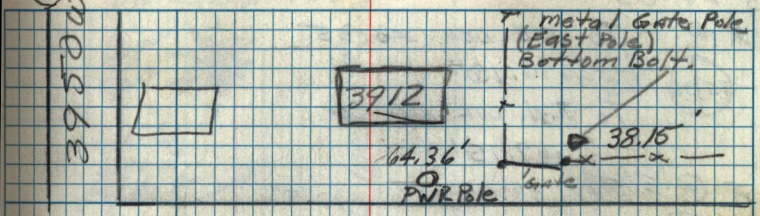

1800 South

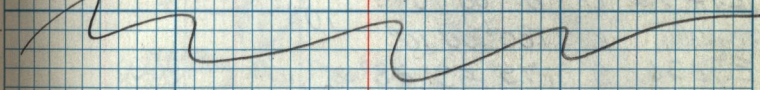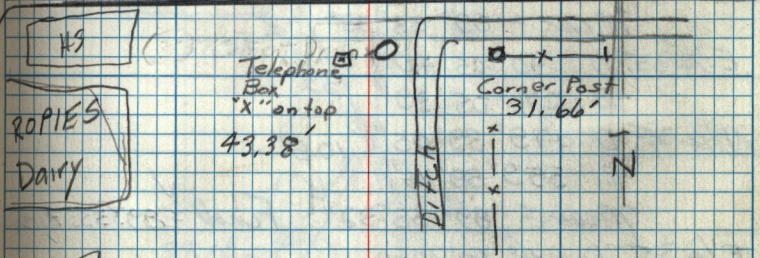

5-20-83

