BH & MH 1-26-84

Monument 1963
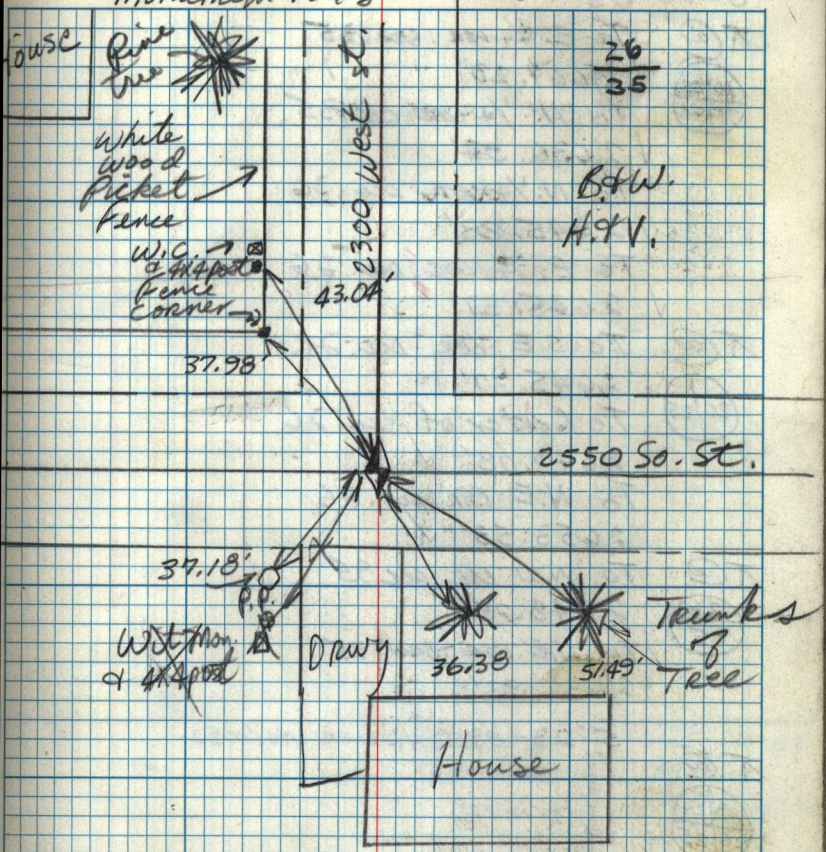
T. 6 N.
R. 2 W.