

P.T. 28A

South Line  
Sec. 28

(22)

T. 6 N. R. 2 W.

(N. & E. 2' Ref. nails)  
nail & Flagging

2550 50'


← To S.W. 28

→ To S. 1/4 28

4050 W.

1/25/84 NW Cor 33  
1962

28/27  
33/34

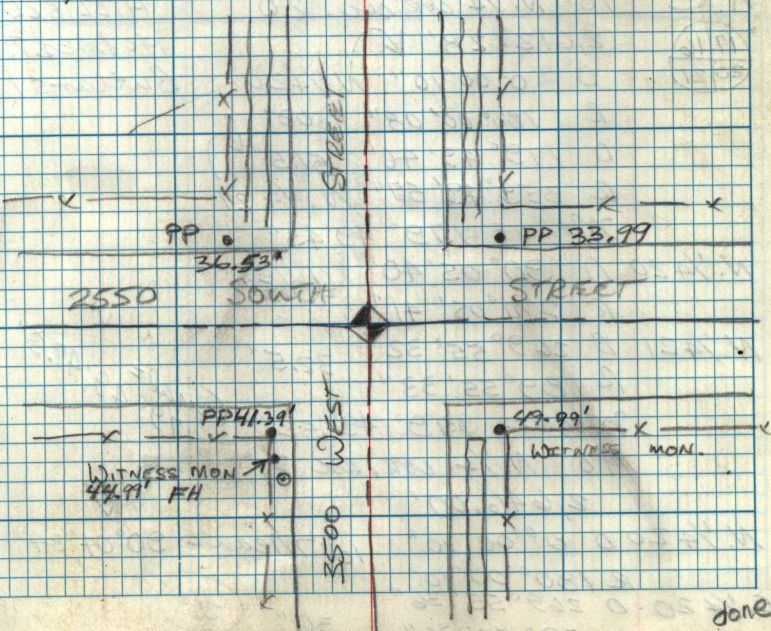

done