


Sec. 25

T.G.N.;  
P. 2 W, 8-02-83

36

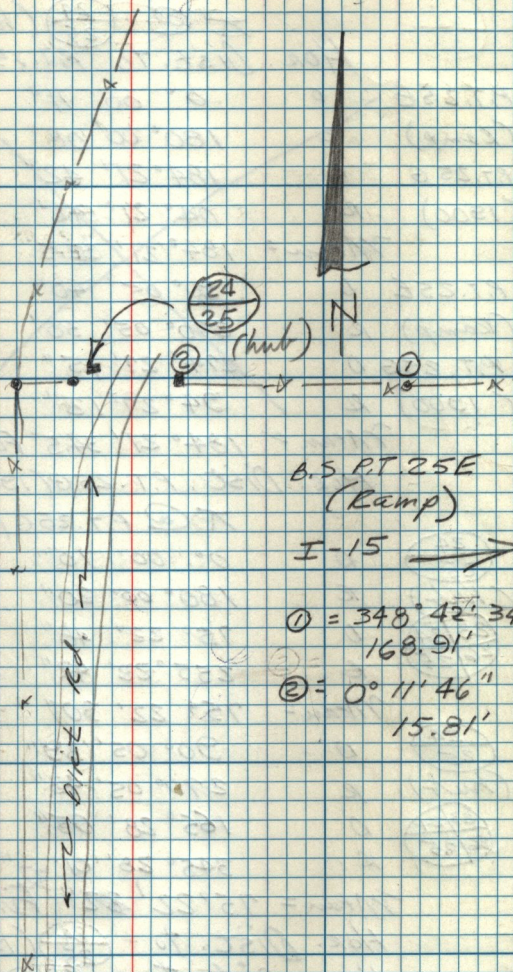

B.S. PT. 25E  
(Ramp)

I-15 →

① =  $348^{\circ} 42' 34''$   
168.91'

② =  $0^{\circ} 11' 46''$   
15.81'


Layton Canal

↓  
To  
Wilson Ln.