

14
23

22 N


12-13-88

48

3" Brass 1965

Nestled in River Bottoms

☒ = 4x4 Post

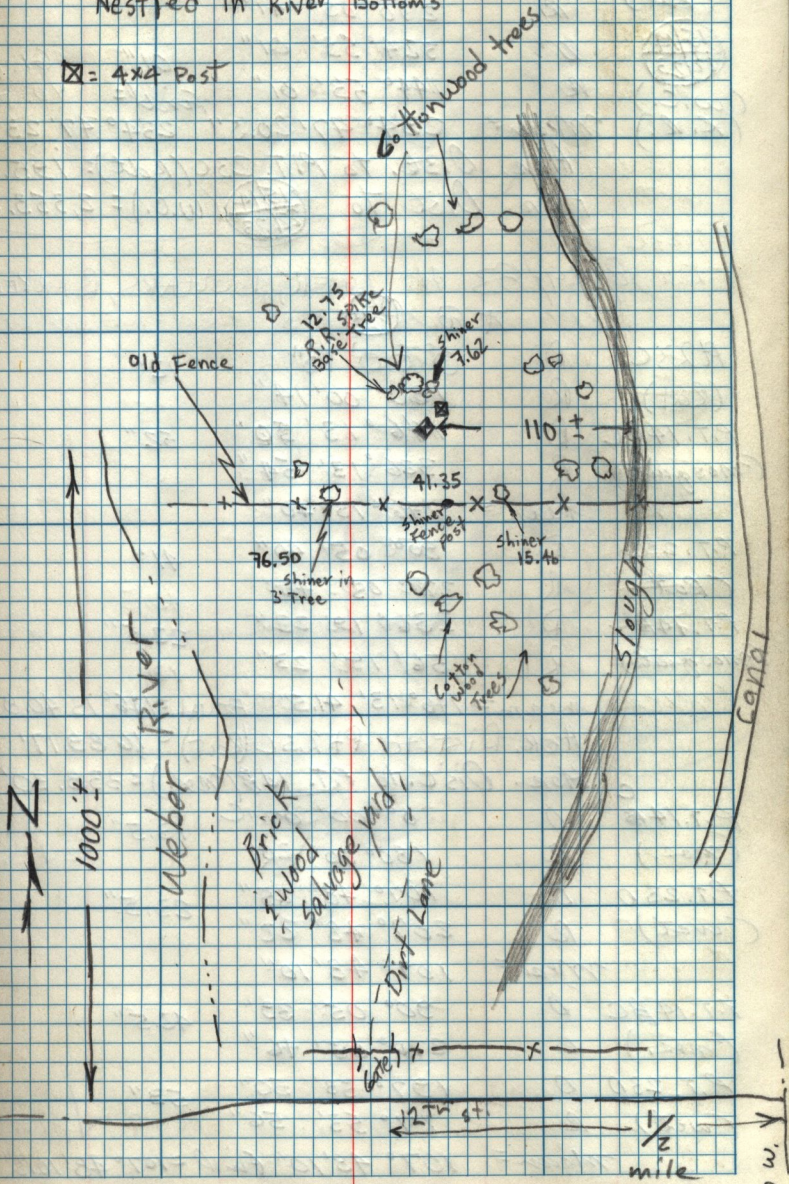

1900 w.