


T. 6 N. R. 2 W. Sec. 24

8-23-83
Lidh. station
#2

I-15

#1

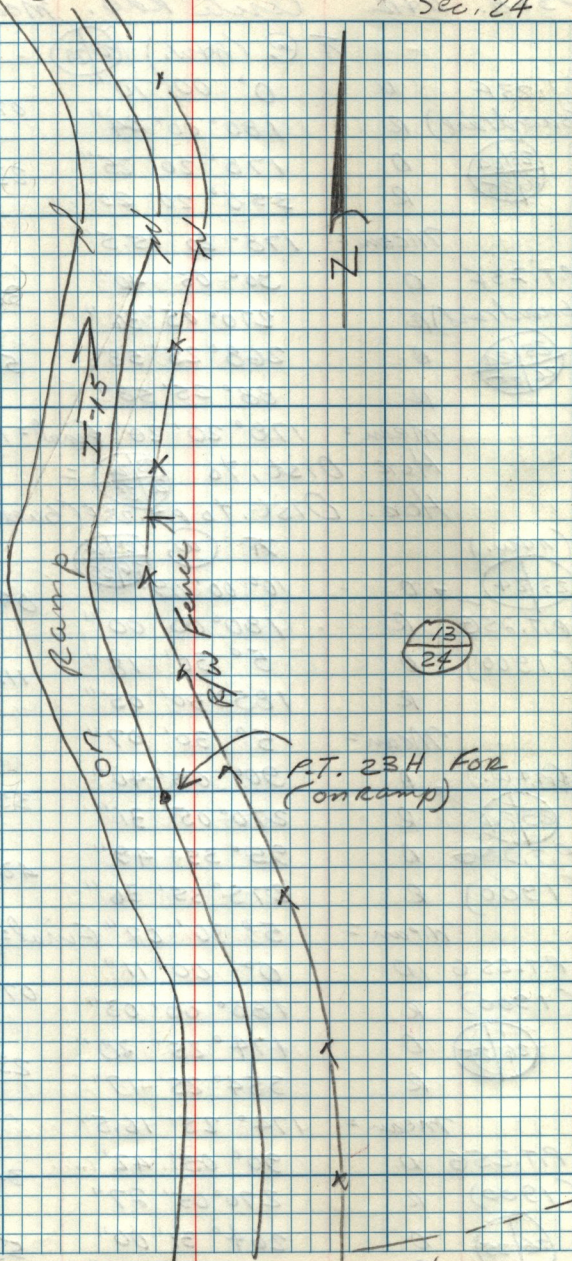

13
24

PT. 23H FOR
(on ramp)

12th St.