


15 | 14

Weber Co.
1961




200 So

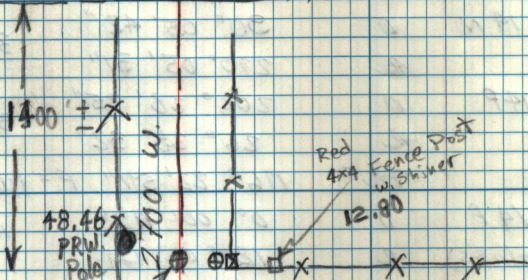

Red 4x4 Fence Post
w/ Shiner
12.80

33.05
Witness
Monument

Tree
w/shiner
117.34

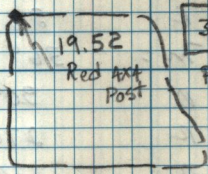

Weber River

To 12th Street