
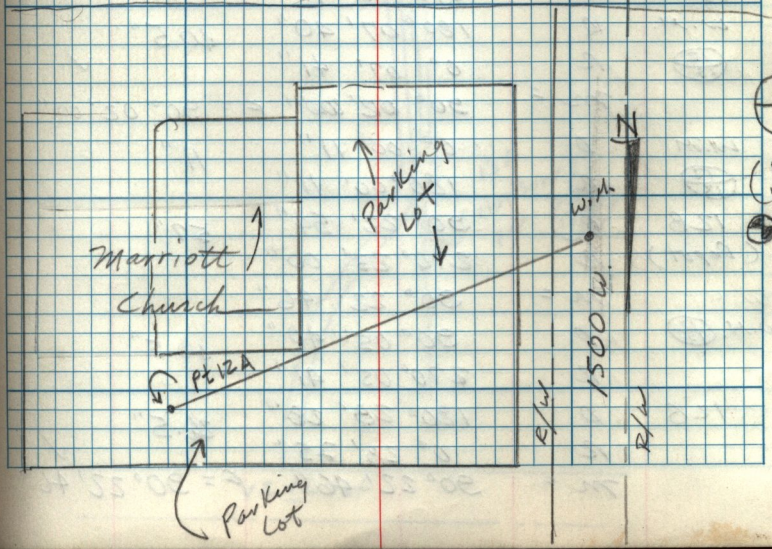


T.6N. R.2W.

### Slateville Area

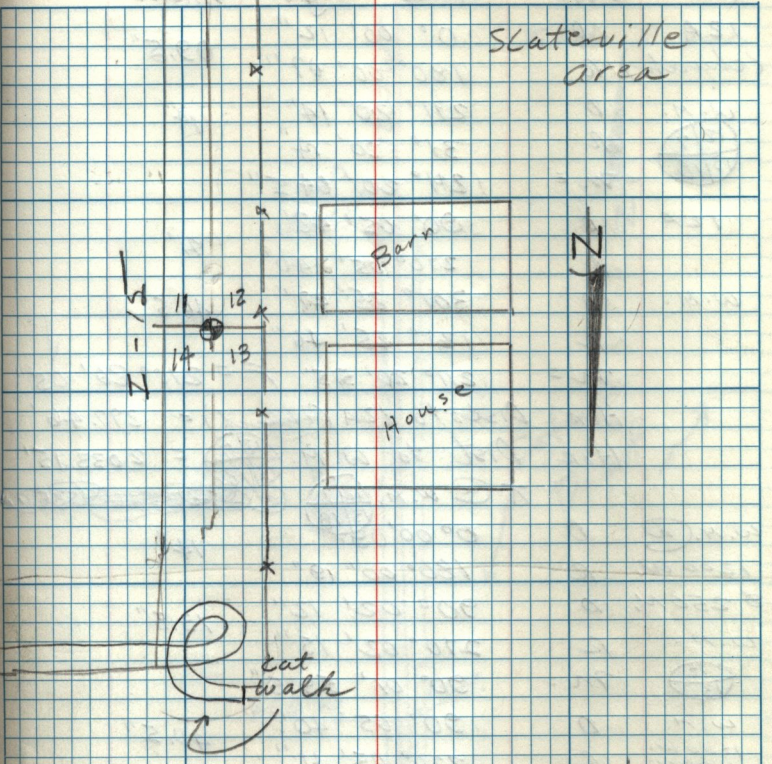

12  
13

(No Mon.)

