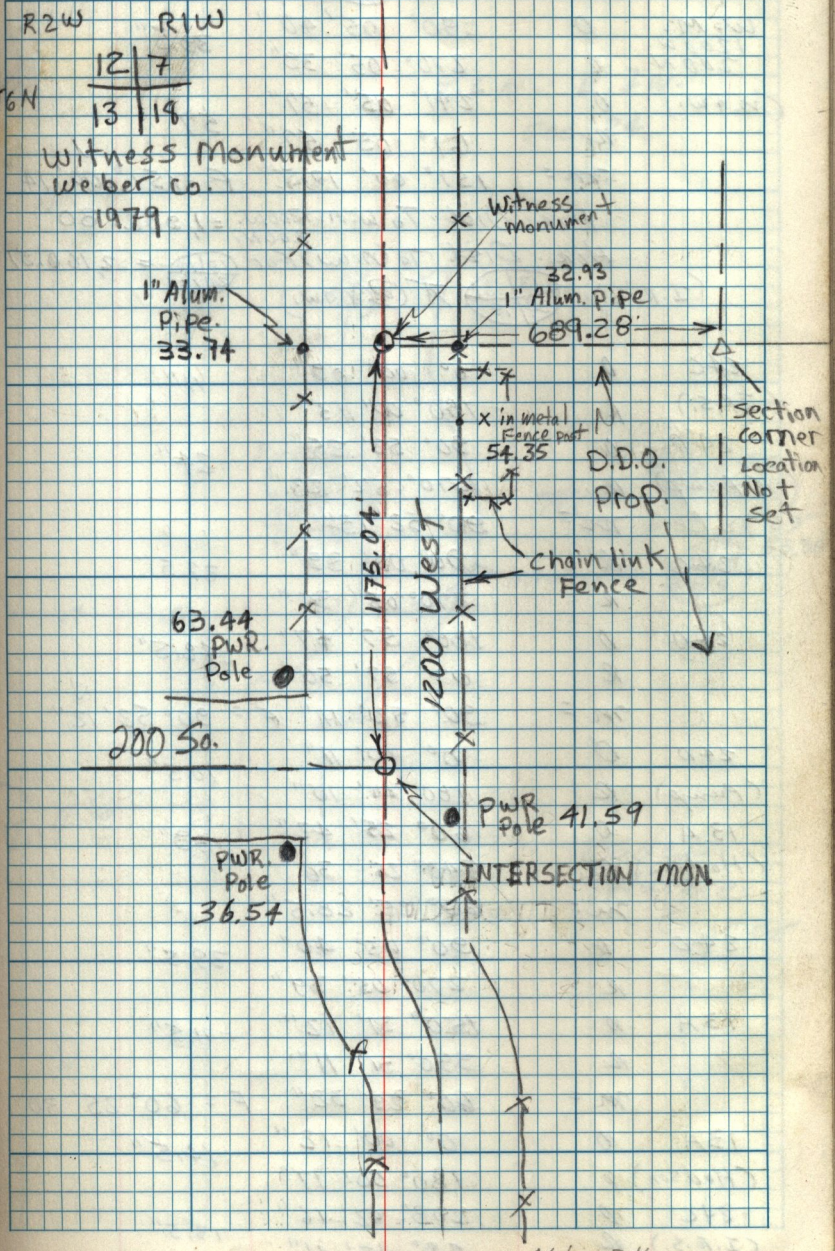
R2W
R1W
12
7
T6N
13
18
Witness Monument
Weber Co.
1979
Witness Monument
32.93
1" Alum. Pipe
689.28'
1" Alum. Pipe
33.74
x in metal Fence post
54.35
D.D.O. Prop.
Section Corner Location Not Set
Chain link Fence
1175.04'
1200 West
63.44
PWR. Pole
200 So.
PWR. Pole 41.59
INTERSECTION MON.
PWR. Pole
36.54
179° 46' 03"