


Sec. 12

T6N. R2W.

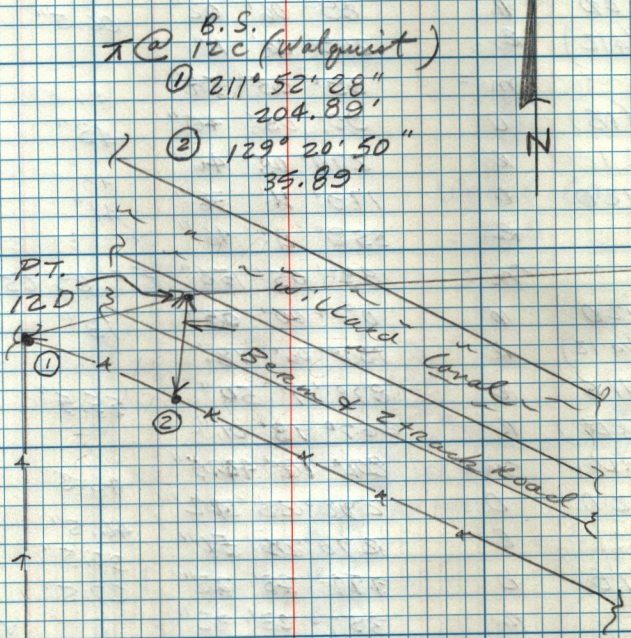

→ Hor. Dist. to 12c (Wal.) = 2,033.60'
 Hor. Dist. to $\frac{21}{1112}$ = 2,597.53'