


2-21-85

D. LEE
D. BUTTARS
T. WOOD

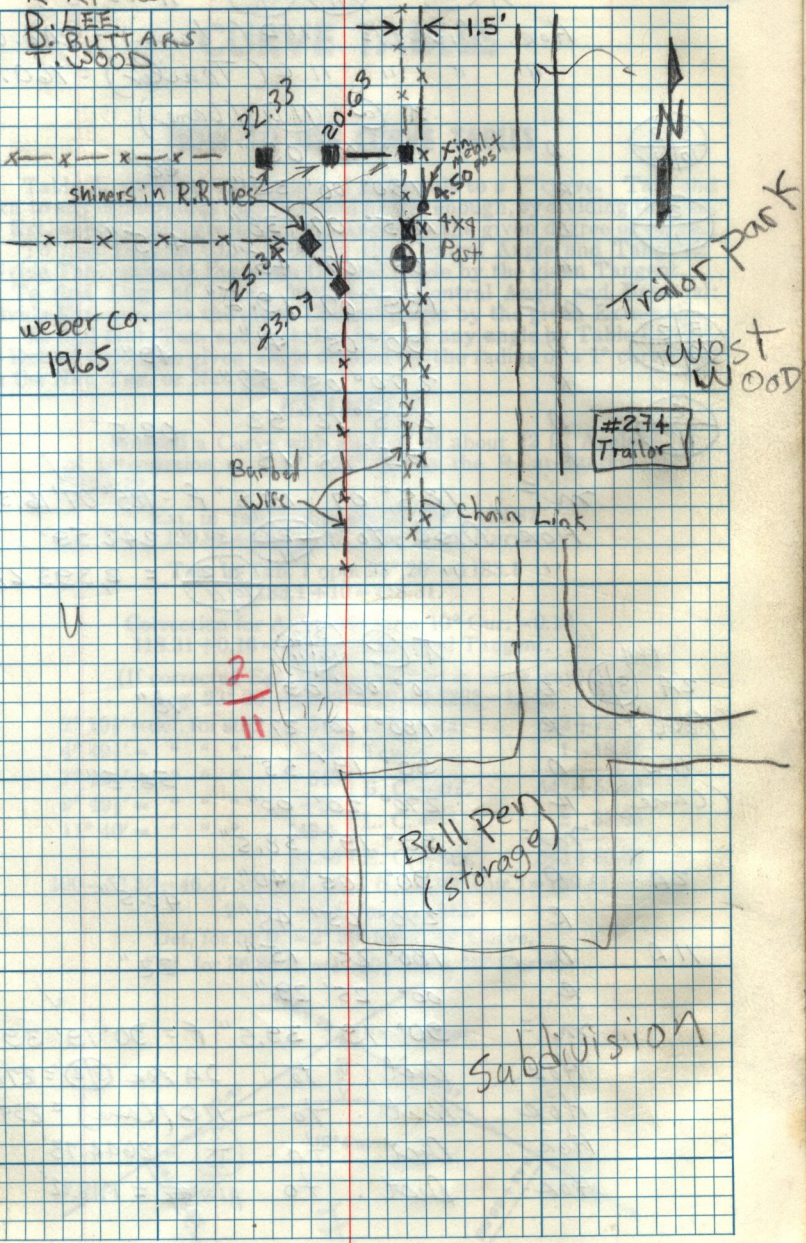

shiners in R.R. Ties

weber Co.
1965

Trailer Park

West
WOOD

#274
Trailer

Barbed
Wire

Chain Link

Bull Pen
(storage)

Subdivision

2
11