


HILLIER  
HOLMES

11-09-83 ①  
T.G.N.R. J.W.

Z

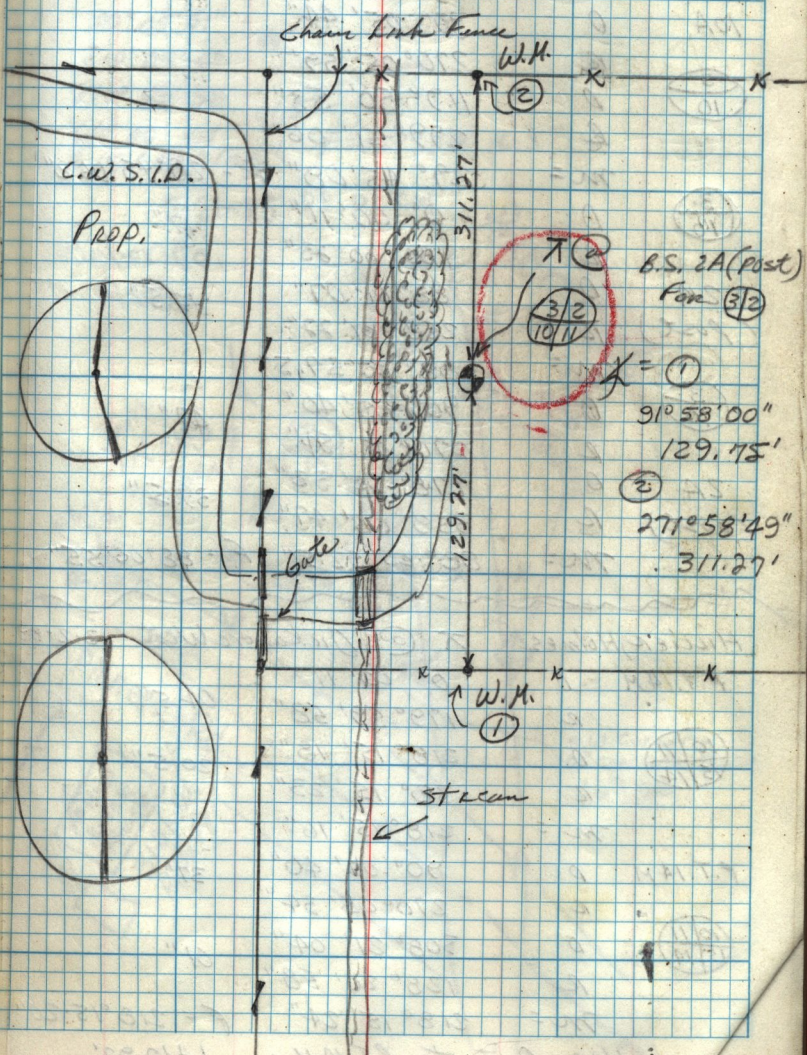

14081

W.M. ①