


20/21 2/13/85 T. Wood
29/28 D. Lee

(6)

Weber County
1963

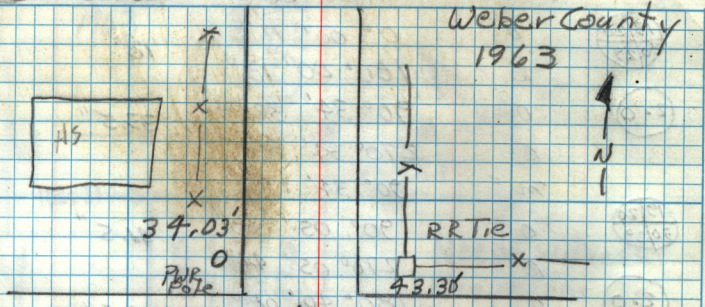

1800 South

"x" in Headgate $44.28'$

45

$78.69'$
PWP Pole

Brass Washer + Nut

4300 W

