


12-6-83

Sec. 32

T. 6 N.  
R. 2 W.

(9)

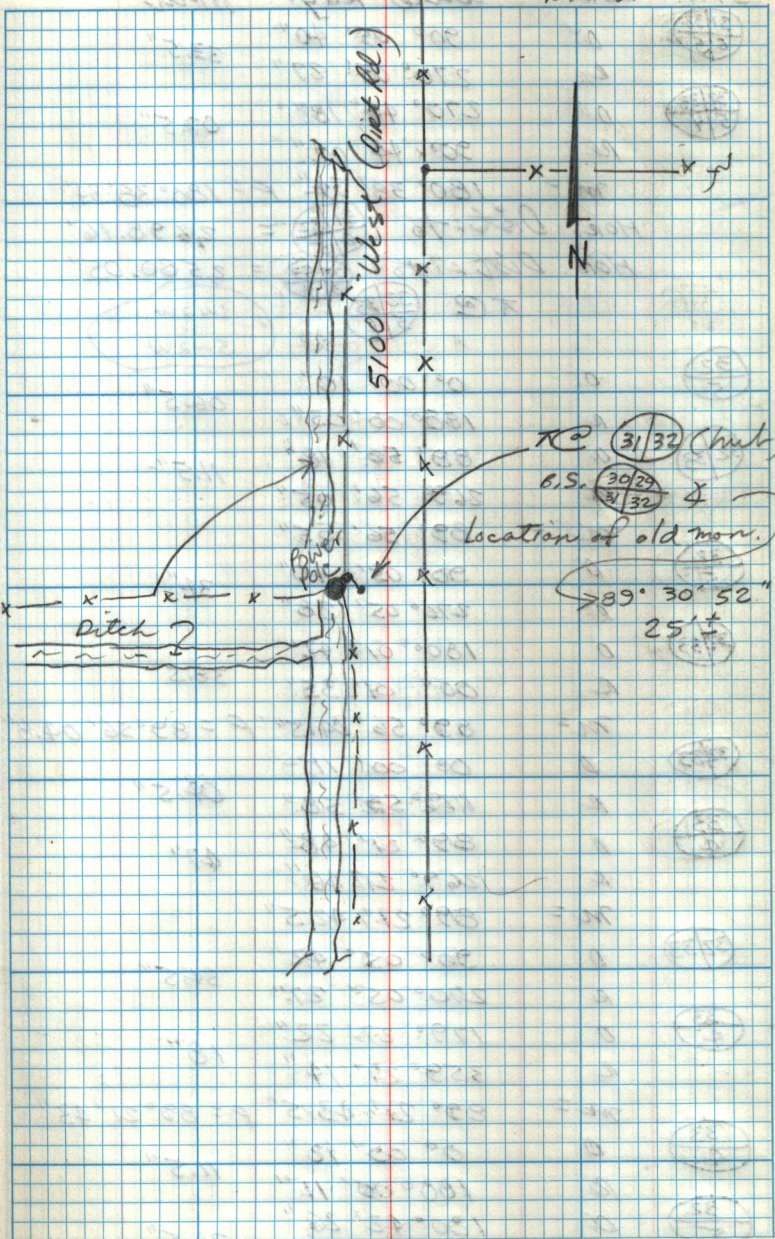

31/32 (hub)

B.S. 30/29  
31/32

Location of old mon.

$89^{\circ} 30' 52''$   
 $25' \pm$

Ditch?

West (Dirt Rd.)  
5100

N