


D. Kuttars  
D. Lee  
T. Wood

Dec 1984





34/35  
3/2

(26)

1972

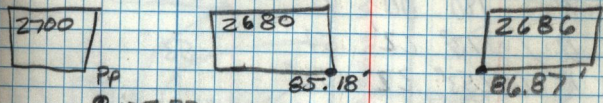

1900 N

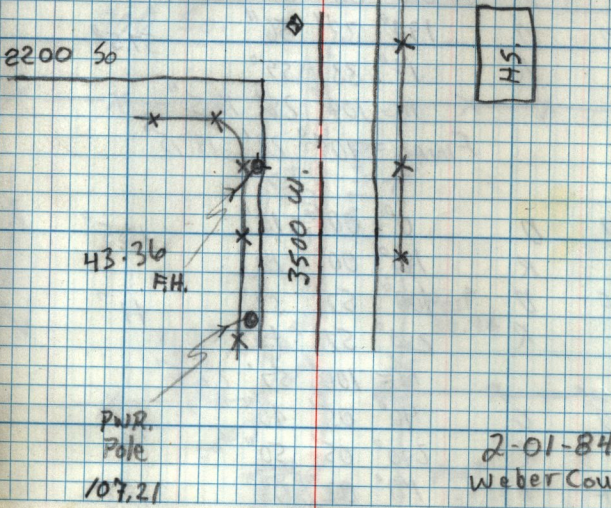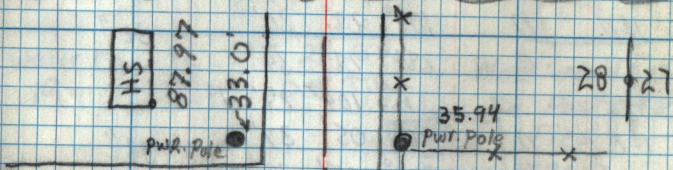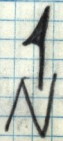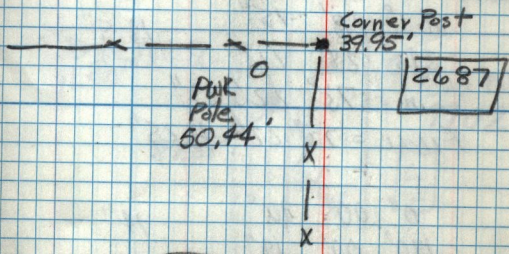

2-01-84  
Weber County

1963