
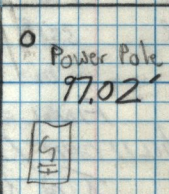
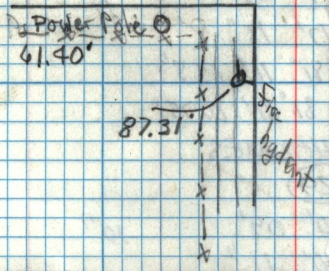


21/22

Weber County 27
1963

2/19/85

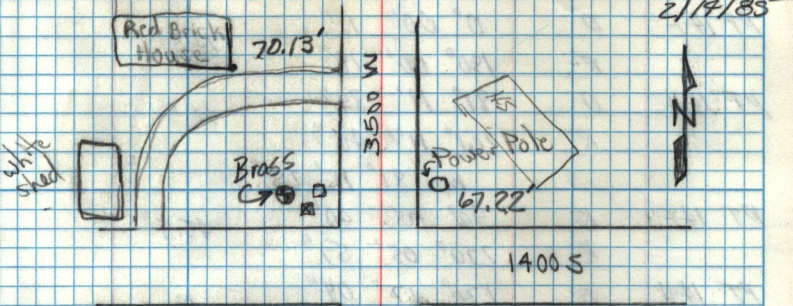


Weber Co. 19

16/21

2-22-85
D.B. T.W.

Note: Nail & shiner
In Posts & R.R.
Ties.

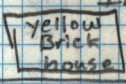

3784 W.

900 So.

