

(22)


Tree  
77.61'

1963  
Weber County (29)

Brass  
4x4 Post

53.15  
PP  
Gate

400 South

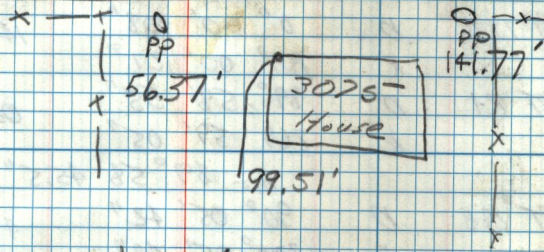

2/19/85

Center of section 22

need witness mon.