


2-19-85

D.B.
T.W.
P.L.

HS


1384 South

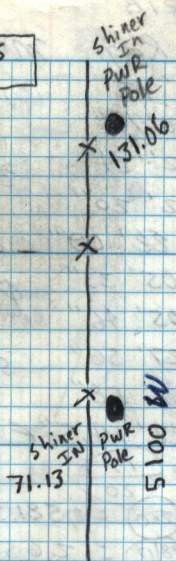

5100 W

19/20

Weber Co (55)
Brass
1963

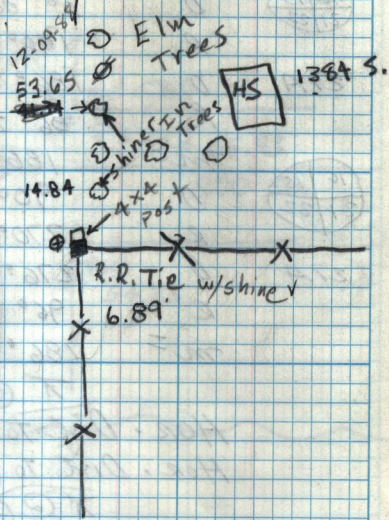

HS

1384 S.