

FLY TIES

T @ 31B
(000)


B.S. 31A
(Swamp)

& RT.

① = $90^{\circ}10'50''$
107.0'

② = $55^{\circ}28'39''$

126.55' 31B
(000)

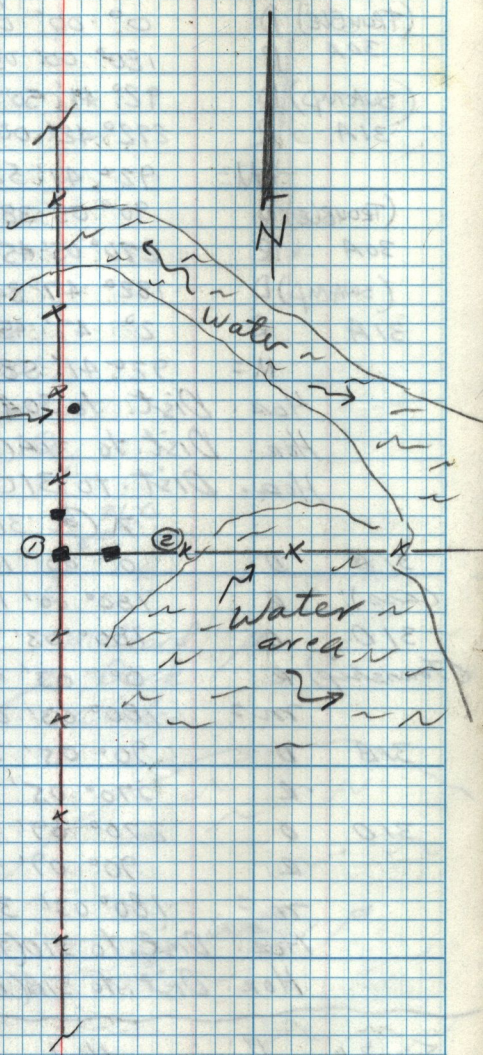

$F = 179^{\circ}22'31.5''$