
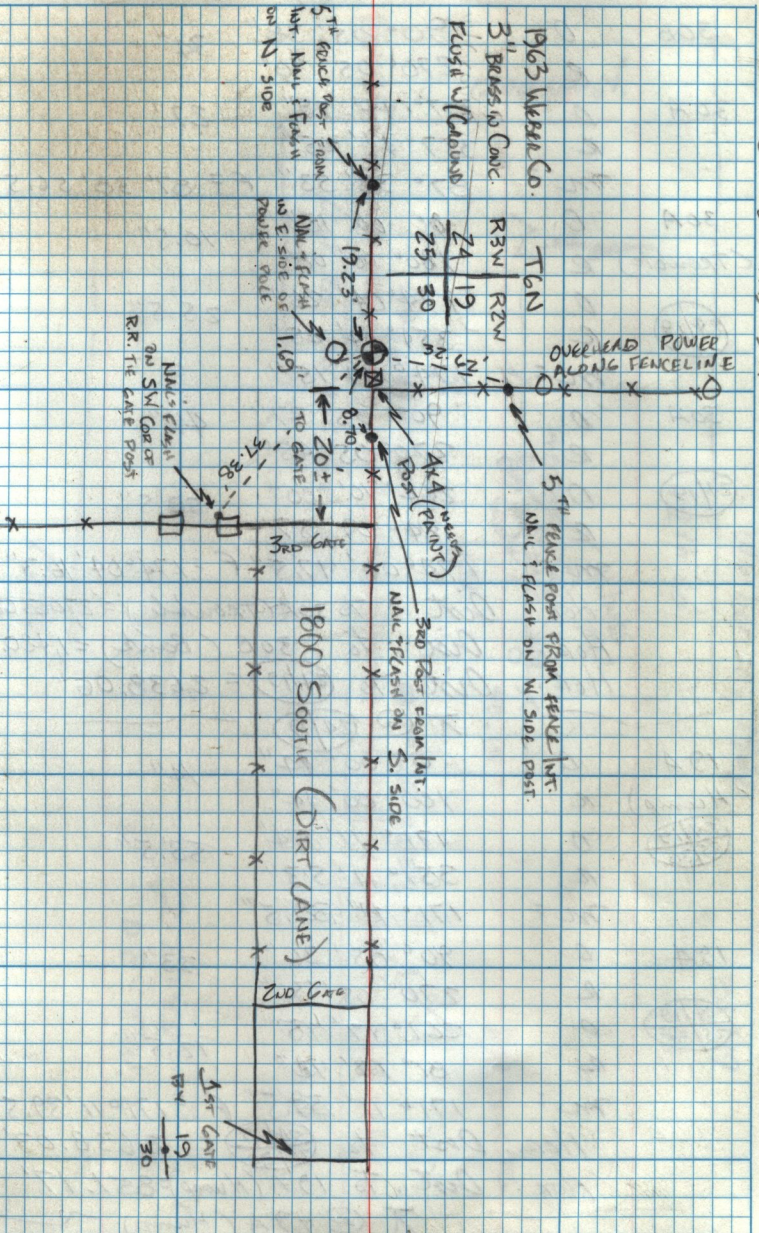


12-9-88 D.B.-R.B.-B.A.

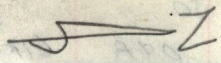

old abandoned Turkey Farm