Weber Co. Brass
1963
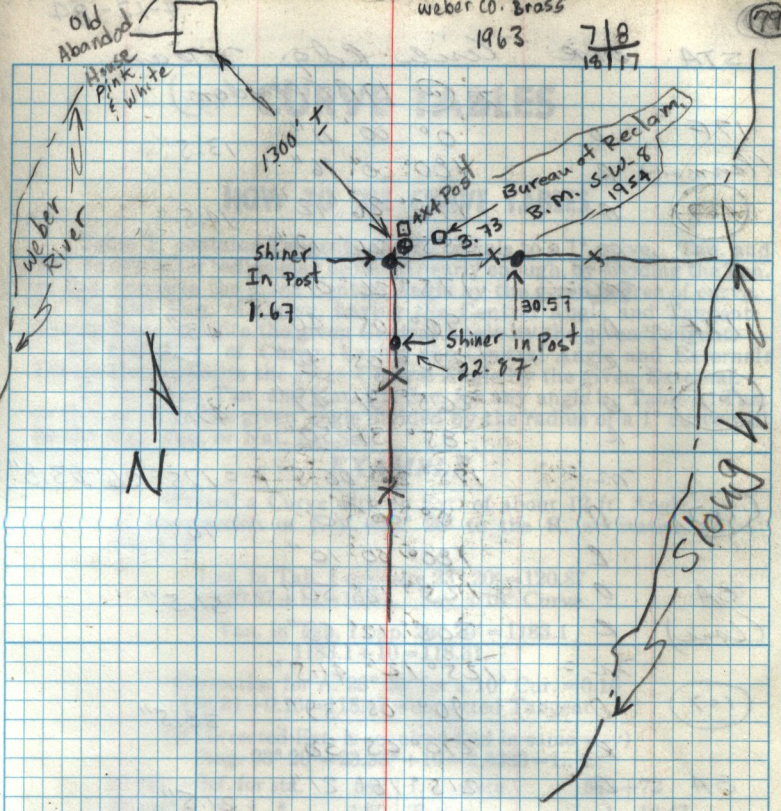
7/8
18/17