


O.B.
R.B.

12-7-88

(3)

8/9

1963 3" Brass
18" Below Surface

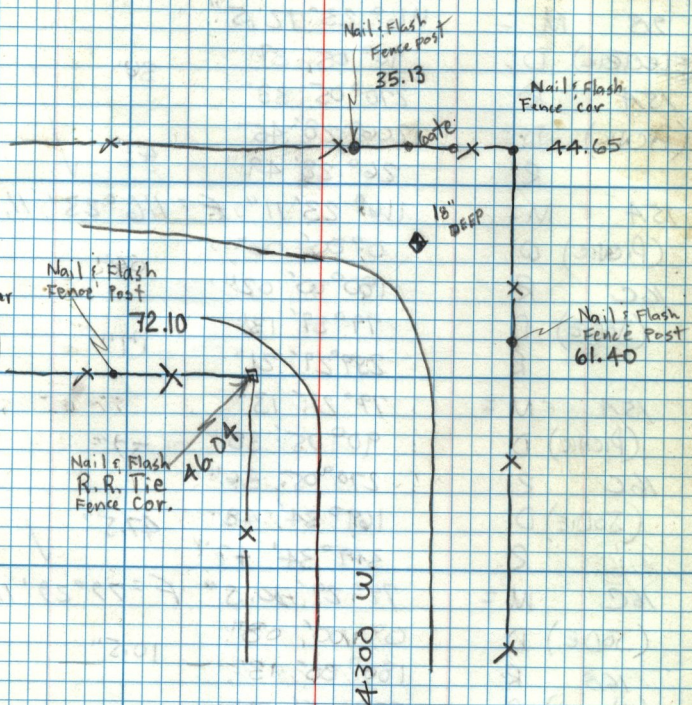

to w. weber cemetery

This cor. was Not FND
Till 12-7-88