

Sec. 9
Hiller, Holmes


4-26-84

(14)


Plain City

T@9C

(Snake)
B.S. 10A (Riverside)
Right 65° 07' 02"

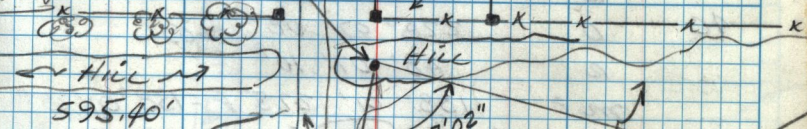

Note: Found
Brass Cap Weber
Cty. (No Record)

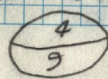

River Bottoms