


4.24.86

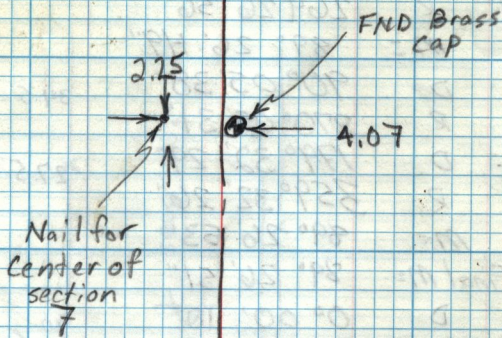

5500 W

$\pi @ \frac{12}{13} \frac{17}{18}$
 12/7 D $0^{\circ} 00' 08''$
 R $179^{\circ} 59' 51''$
 ⑦ D $44^{\circ} 40' 35''$
 R $224^{\circ} 40' 21''$

300 N

T6 N

$\pi @ \frac{12}{13} \frac{17}{18}$

R3W R2W

B.S. 12/7 @ $0^{\circ} 00' 00''$

~~X RT $44^{\circ} 36' 34''$ Dist 3786.58 ^{True} Nail for ⑦~~

X RT $44^{\circ} 40' 25''$ Dist 3788.06 ⑦