

D. LEE
 T. WOOD
 2-28-85


27

6/5
 1963



π @ wade
 B.S. 6B (milk)

* RT to 6/5 = $92^{\circ}55'00''$
 $22.43'$

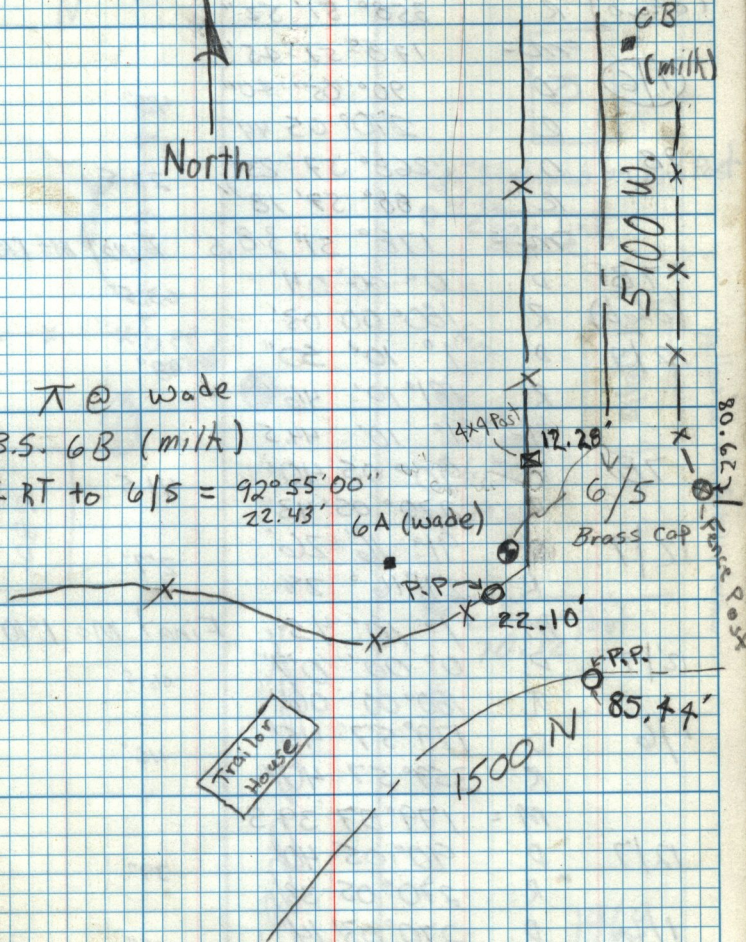

FRP 229.08