
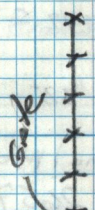


B. Barkins
D. Lee
T. Wood

12-17-84

11/6
12/7



28

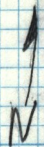

Opp 1
27.48




Yellow Brick

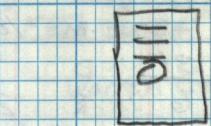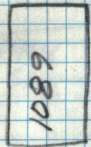

"x" Stamped on End Post
"W.C."
Chain Link
Fence




Nail & Brass
Washer
46.72

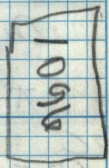

yellow with Brown trim

Dep 39.60

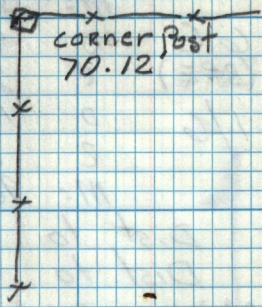

5900 West

1963

Done
25