
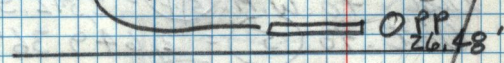


48-01-2

32/5 T6N 35

Cement Wall


Red Brick H.S.

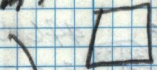

Drive Way

PP 77.29'

Barn

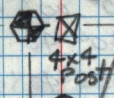

4x4 Post

Man Hole Cover 11.44'

X" Stamped on Cover

PP 17.34

4700 West

1971

done RT