


5/4

38  
12-17-84

D. Butters  
D. Lee  
T. Wood

1500 North

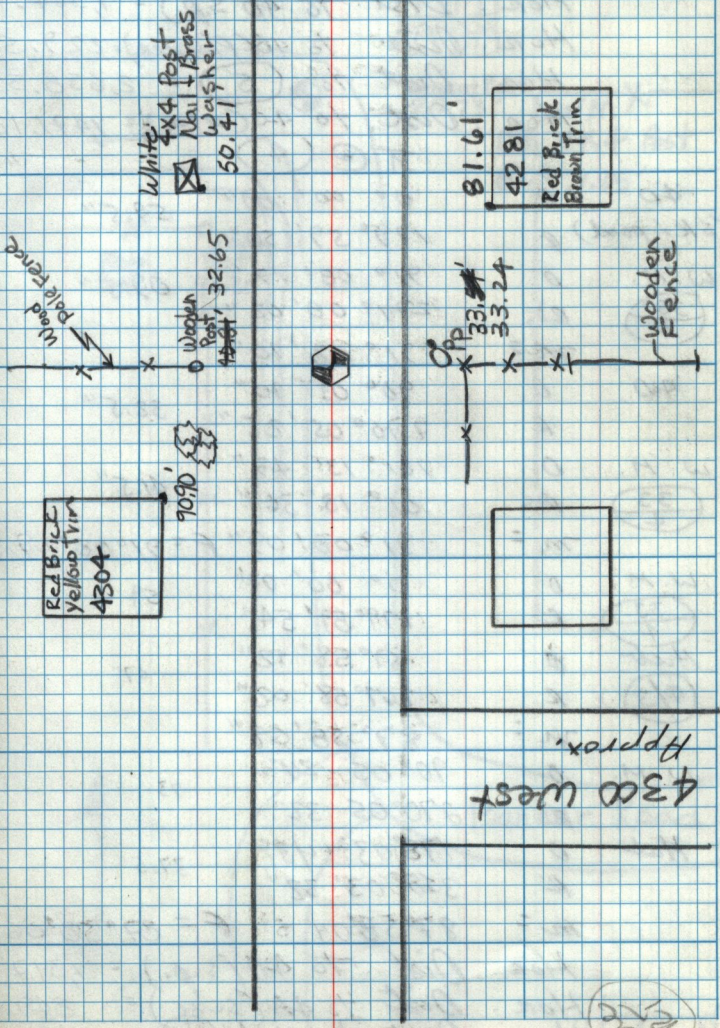

D. Lee