

D. Butters
D. Lee
T. Wood

12-17-84

(4)

39A

Warren Canal




Guard Rail
29.73'

WMX


4x4 Post

71.05'

Ditch

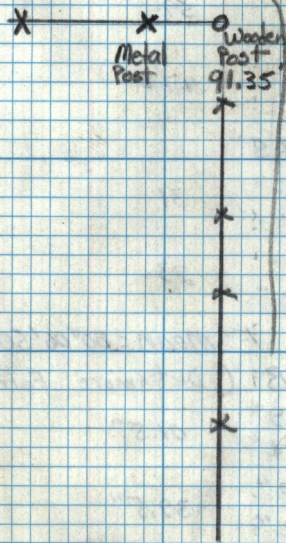

Pioneer Road

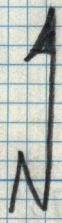

1967 done R/L