




1800N

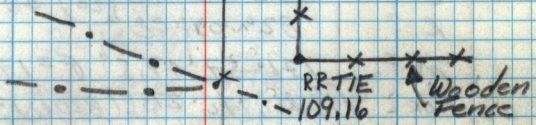

O Cement Head Gate 2' dia  
 "X" Chistled East Side  
 37.00'

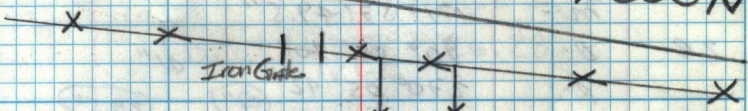

\* Fence Post  
 48.23'

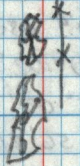

Needs  
 2 W.M. put  
 in.

done  
 12/10