


Fly  
Ties

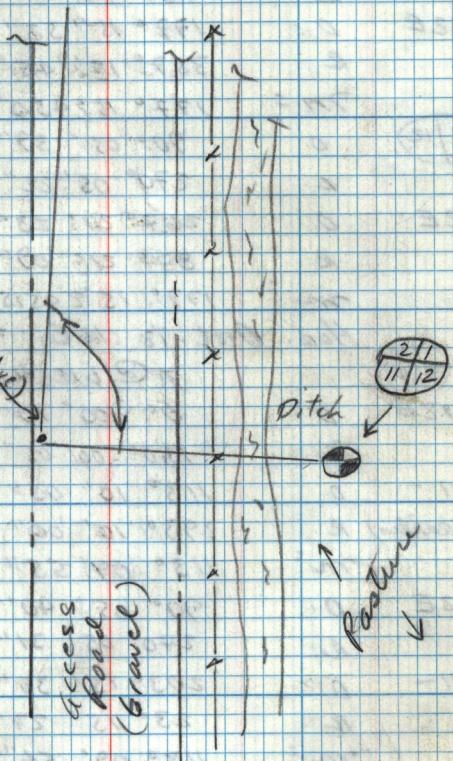

T. @ 12E  
 B.S. N3 (P.R. = Pike)  
 $\angle 103^{\circ} 25' 52''$   
 72.55'



S  
N