



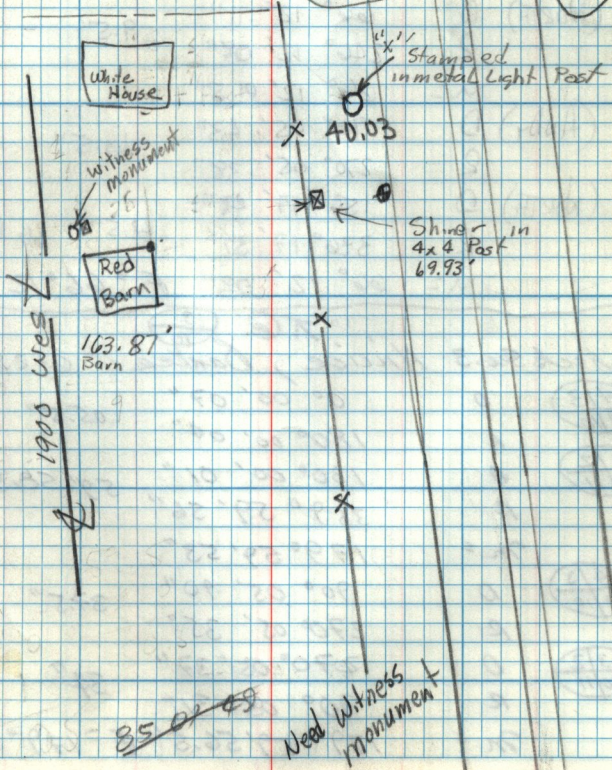

11/12  
14/13  
Weber County  
1982

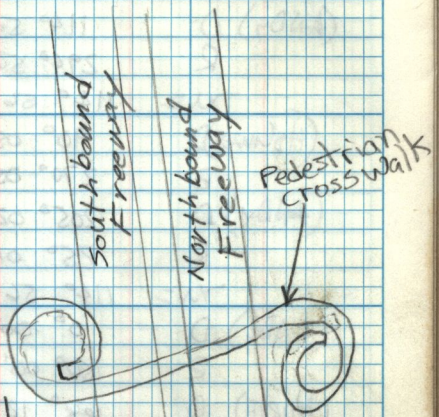

$F = 85^{\circ} 01' 50.5''$