


☒ = witness post
4"X4"

4/3
9/10

1963
N

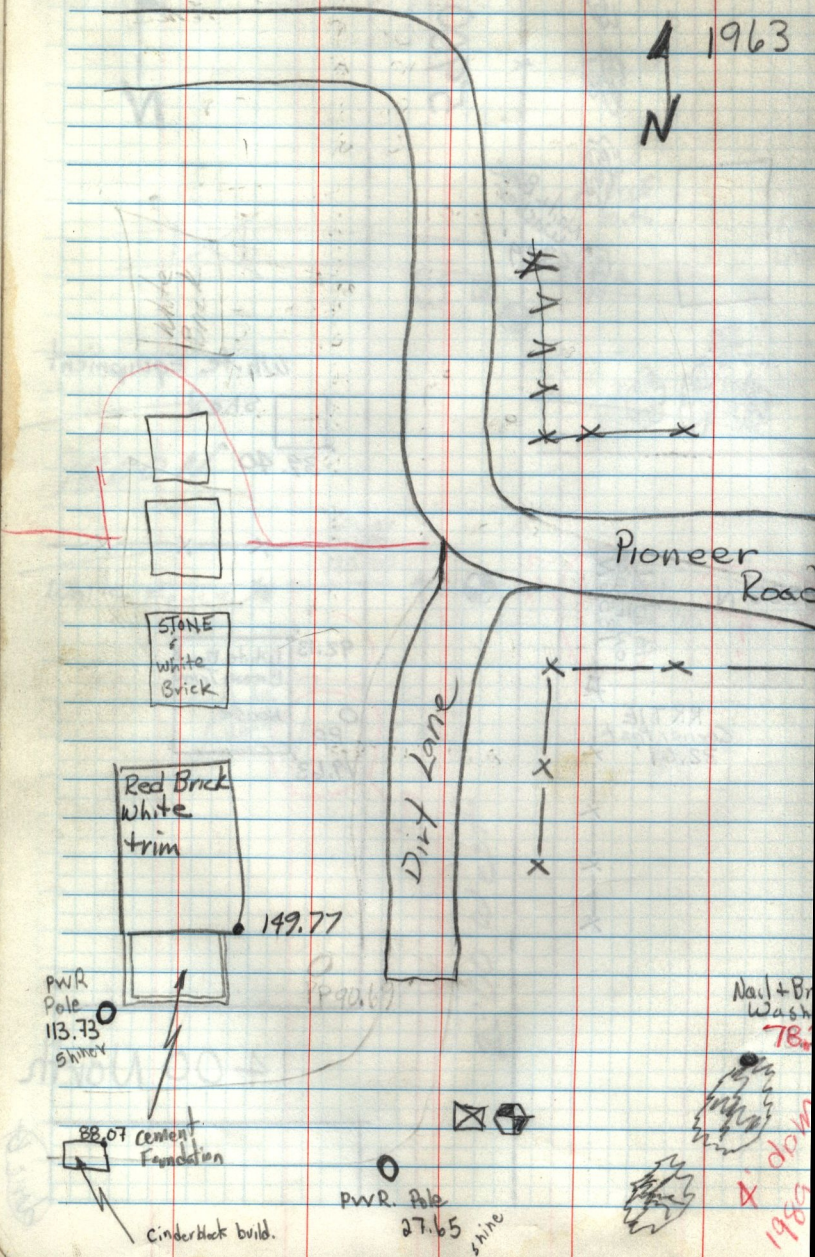

STONE
&
white
Brick

Red Brick
White
trim

149.77

PWR
Pole
113.73
shiner

88.07 Cement
Foundation

Cinderblock build.

PWR. Pole
27.65
shiner

Nail + Br
Wash
78.0

1980