


2-25-85
D.B. / D.L. / T.W.

34/35 weber co. 1963 64

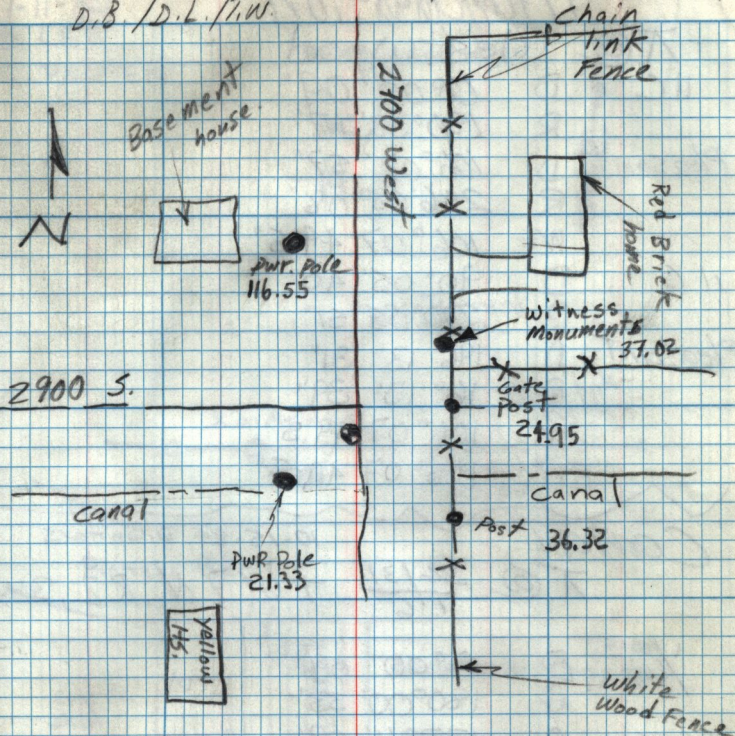

Nail & washers in pwr pole, posts.