

Weber Co.

1963


$\frac{13}{24}$

TGN  
R3W

3-5-85

D.B. D.H. T.W.

(2)

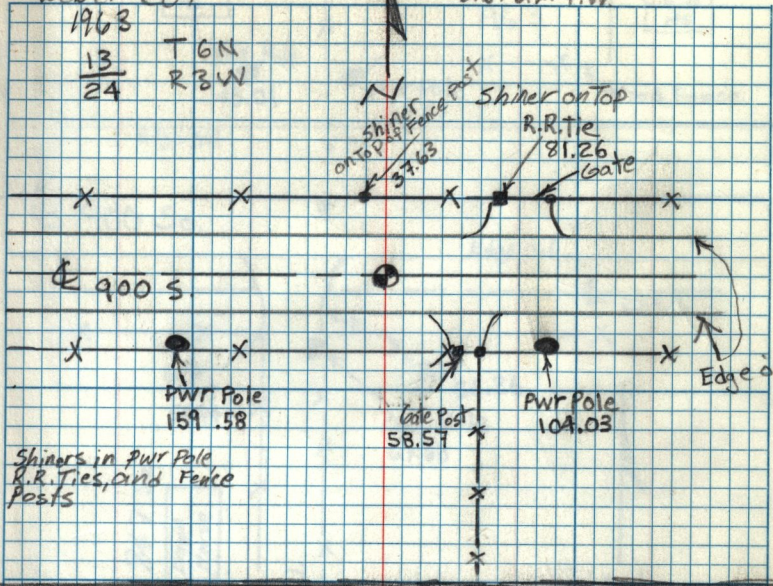

Shiners in Pwr Pole, R.R. Ties, and Fence Posts

3-5-85

$\frac{14}{23}$

Pwr Pole  
73.94


rees

53

Fence Post  
45.16

White

Old church  
Converted to  
A House

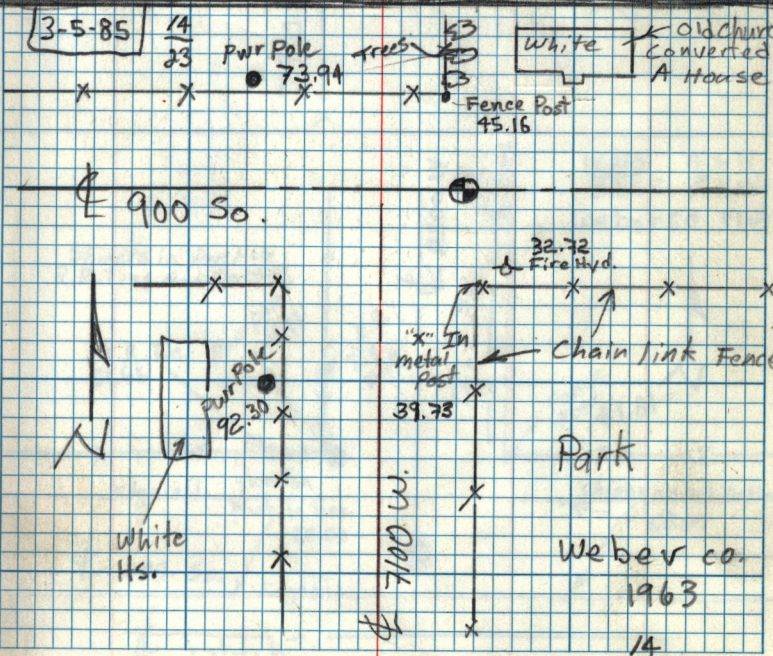

TGN R3W

$\frac{14}{23}$