

3-5-85


7846 W

Orange Hs.


Weber Co. 15
22

T6NR3W


(3)

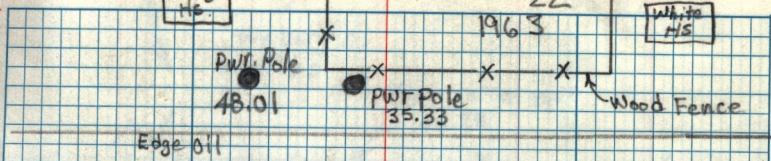

900 So.

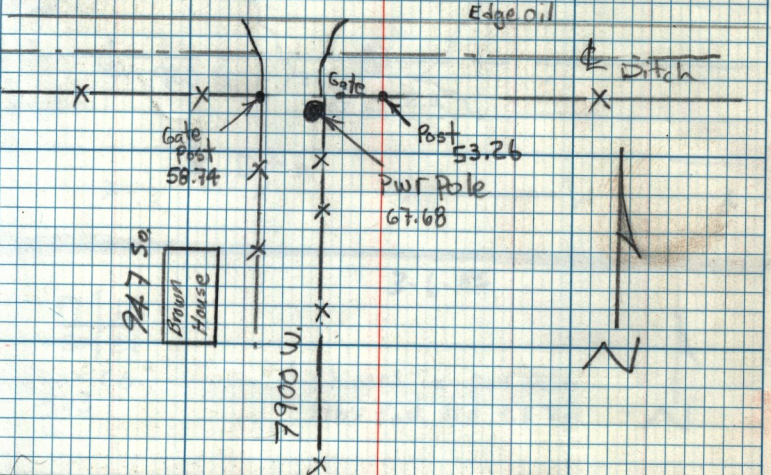

Shiners in Pwr Pole, R.R. Ties And Posts

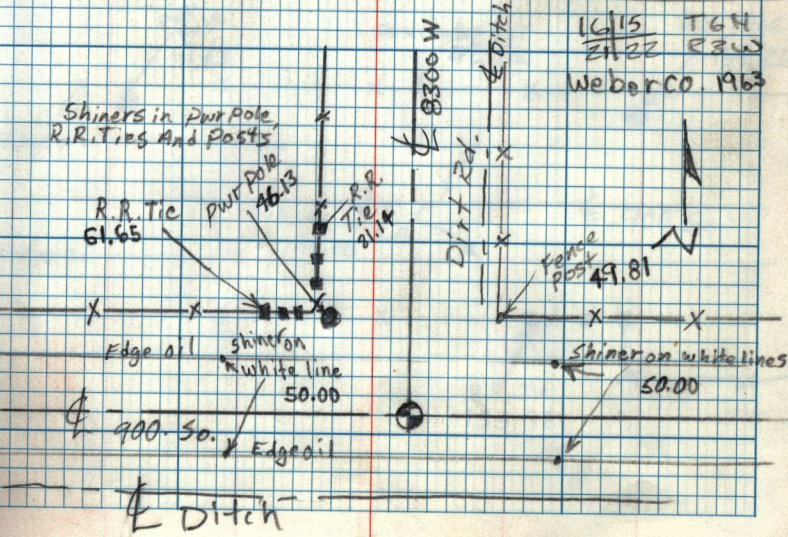

16115 T6N
2122 R3W
Weber Co. 1963