


16
21

3-6-85

(4)

DB, P.L.T.W.

Weber Co.
1963

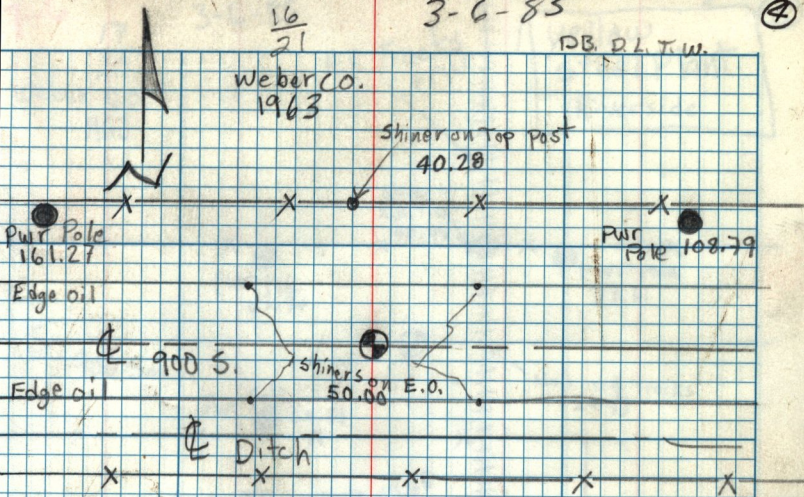

3-6-85

17 | 16
20 | 21

Weber Co.
1963

Shiners in pwr. pole,
Fence Post, and R.R. Ties.

