
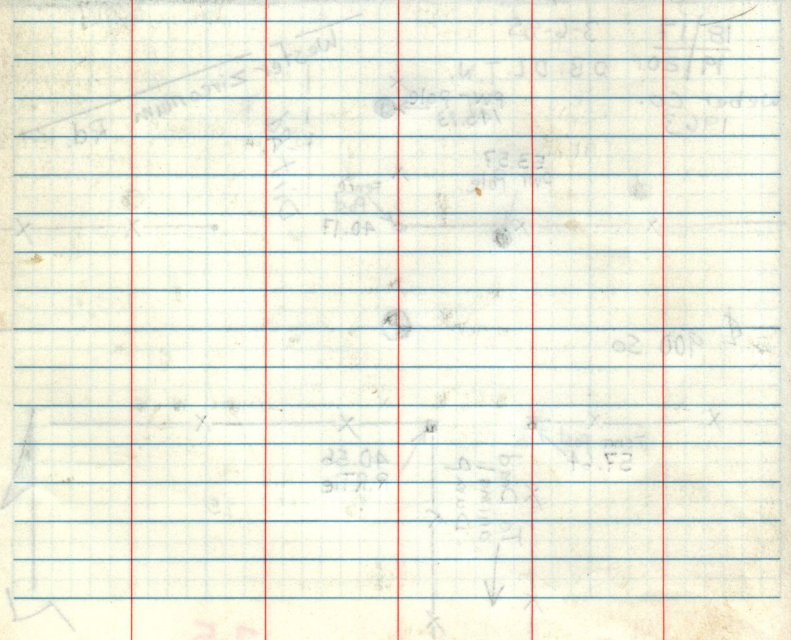


2

VIEW  
STATION  
K. ...

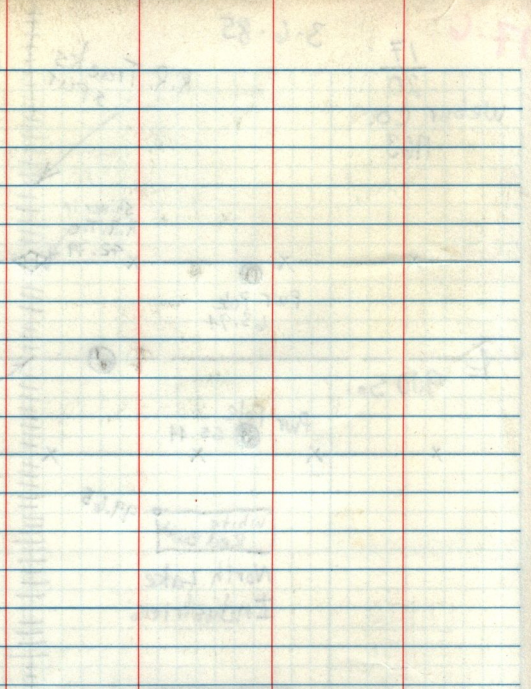

42