

3-6-65


Radio Towers
little mt.

6

T6NR3W
13/18
24/19

17-3

R4W.

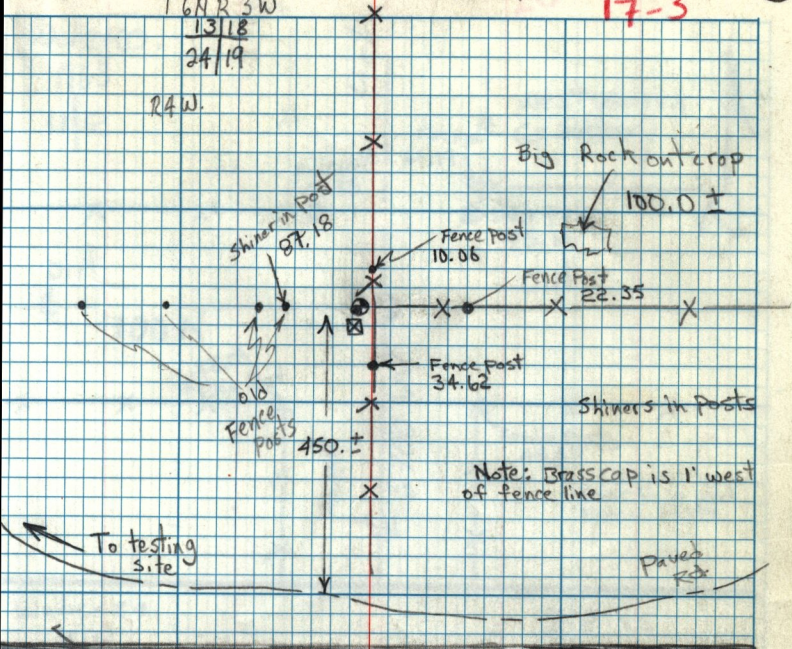

3-6-85

Weber Co. T6NR3W
1978

15/14

18-11

