
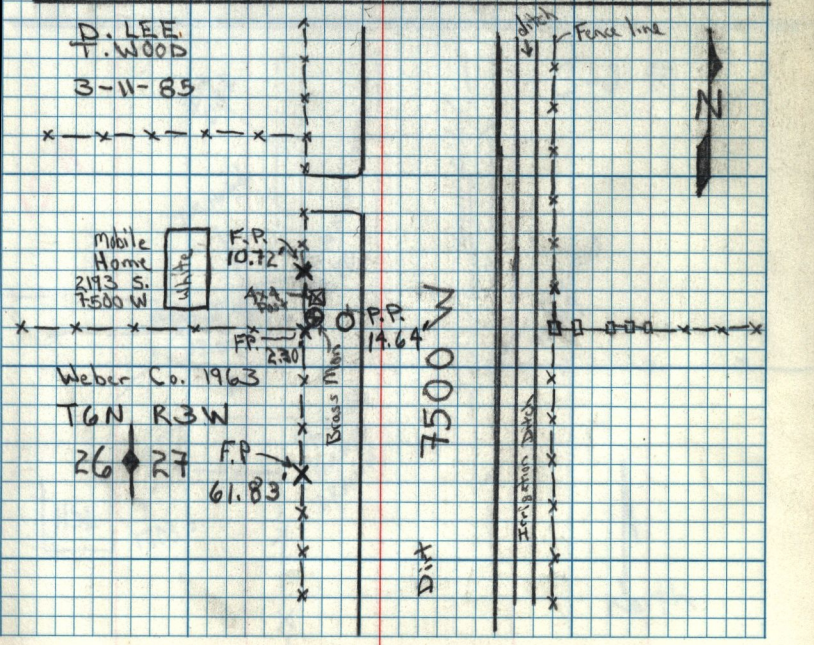


23-13

D. LEE
T. WOOD
3-11-85

9

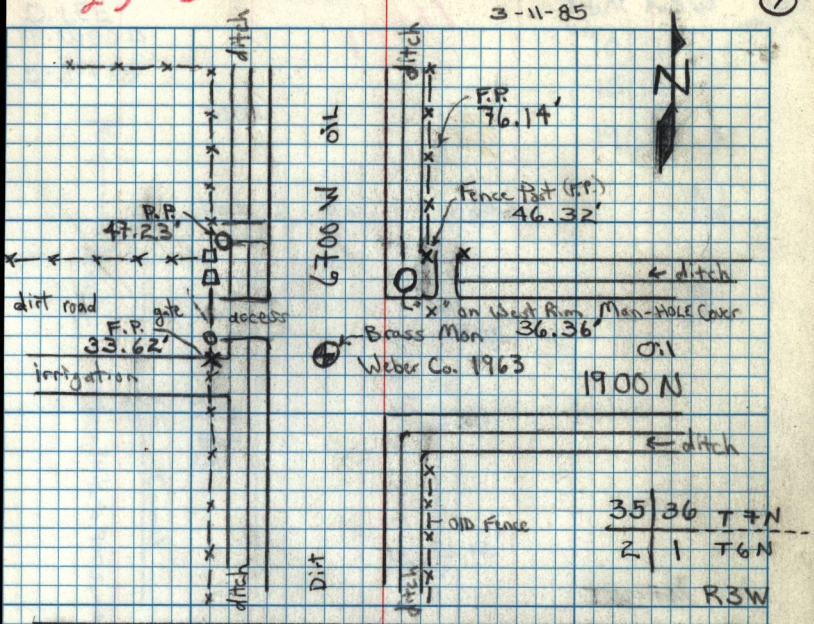

14-11