

D. LEE  
T. WOOD  
5-31-85


19-11

T6N R3W

(10)


10	11
15	14

1963

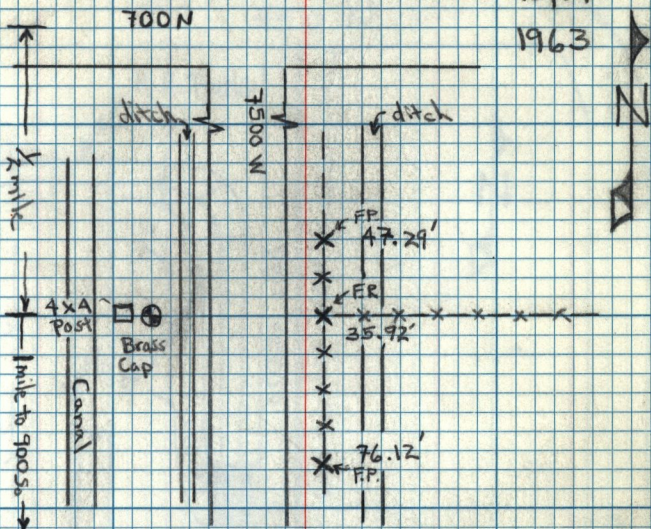

15-11

3-2-89

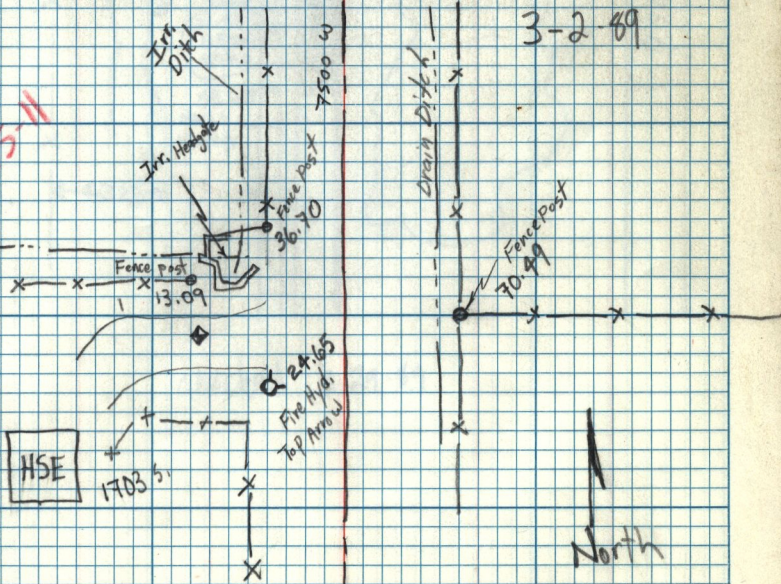

3-2-89

T6N R3W 1963

22	23
27	26