


T6 N R3W

(11)

D. LEE  
T. WOOD  
5-31-85

19-6

8  
17

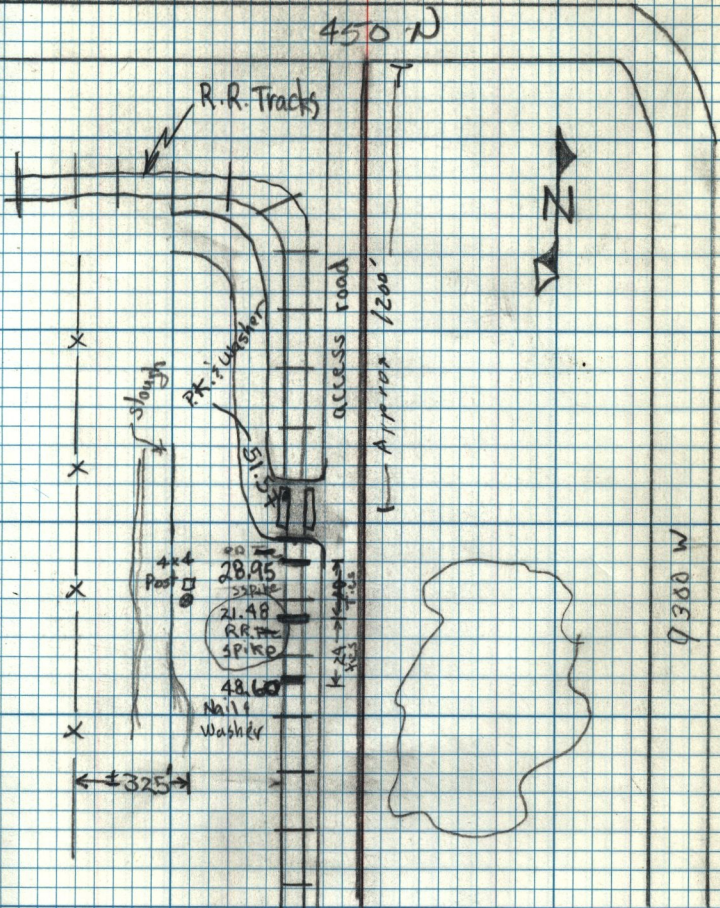

checked 3-29-89