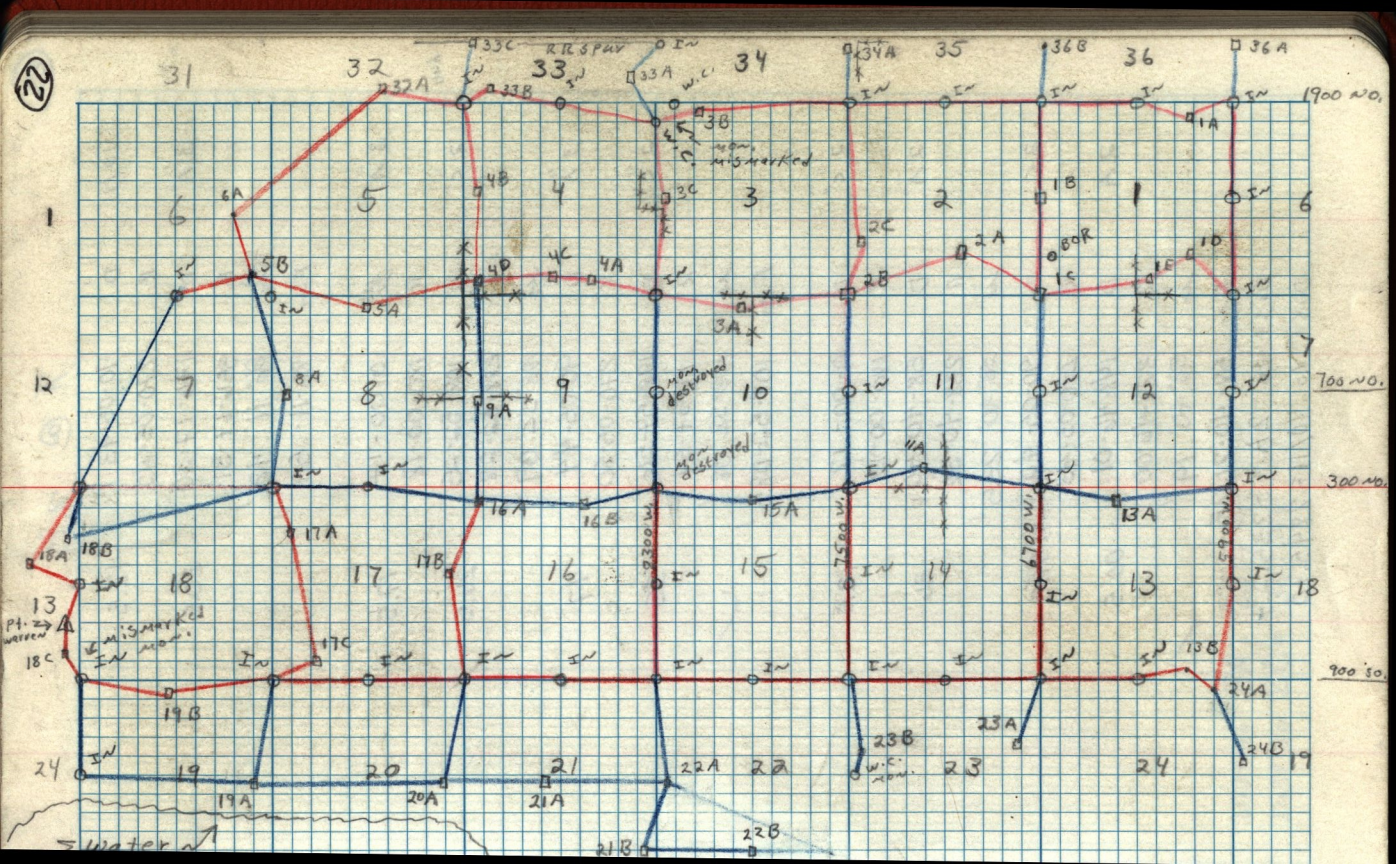
22
31
32
33
34
35
36
R.R. spur
W.C.
1900 NO.
700 NO.
300 NO.
900 SO.
6300 W.
7500 W.
6700 W.
6900 W.
Pt. Warren
Water