


T@ 4B BS  $\frac{32}{5} \frac{33}{4}$

X RT	to	Fence cor.	245-38-00	161.3
		Fence cor.	252-34-50	183.0
"	"	North fence	286-14-30	175.6
		North fence	326-39-10	282.8
"	"	East fence	139-50-10	107.3
		East fence	109-50-50	282.6
		South fence	226-38-20	210.4
"	"	South fence	202-17-00	451.5

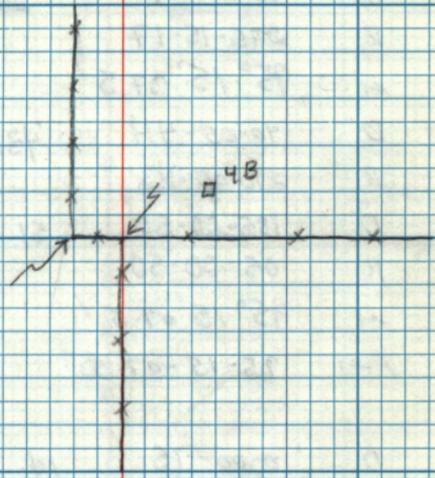

28-8229 = 34 0110.0