

return of 2.5 4/30/86

88-39-06.25
88-46-02.75
91-12-41

(49)

T @ 9/10
16/15

359 59 54.00

15 D 0-00-14 15.5
R 180-00-17
B D 88-46-17 18
R 268 46-19
M 02.5

15 D 90-05-43 46
R 270-05-49

B D 178-51-48 49
R 358-51-50
M 03
FM 88-46-02.75

B D 0-00-15 18
R 180-00-21

A D 180-01-26 28
R 00-01-30
M 10

B D 90-05-48 51
R 270-05-54

A D 270-07-04 02
R 90-07-00
M 11
FM 180-01-10.5

A D 0-00-13 13
R 180-00-13


15 D 91-12-54 54
R 271-12-54
M 41

A D 90-05-44 45.5
R 270-05-47

15 D 181-18-25 26.5
R 01-18-28
M 41

FM 91-12-41

D.SI to 16B = 2559.07
D.SI to 15A = 2635.06
D.SI to 16/15 = 2624.12

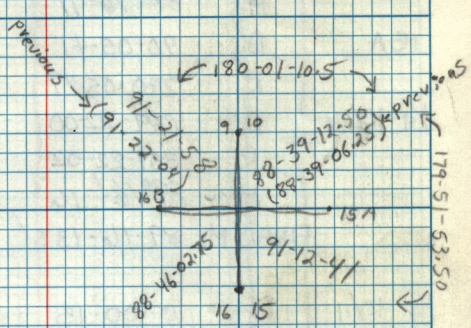

179-51-53.50
91-12-41.00
88 39 12.50

180-01-10.50
88-39-12.50
91-21 58.00