


T@ 13A

BS 11/12
14/13

X RT to Fence corner	166-28-10	716.3
" " South Fence line	188-40-10	722.1
" " East Fence line	169-12-50	1032.9
" " North Fence line	150-35-40	778.2

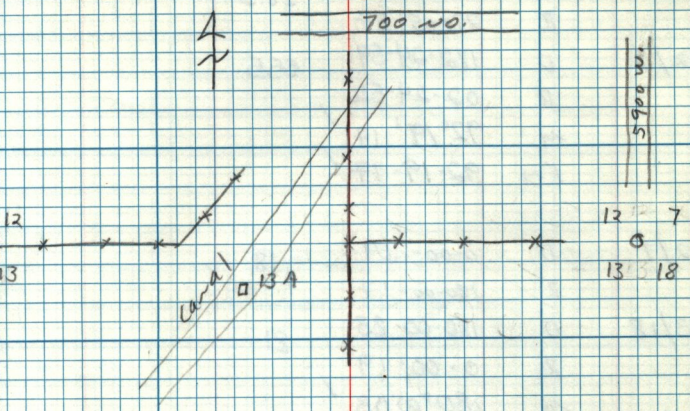

12
13

12 7
13 18