


16-11

3-2-89

64

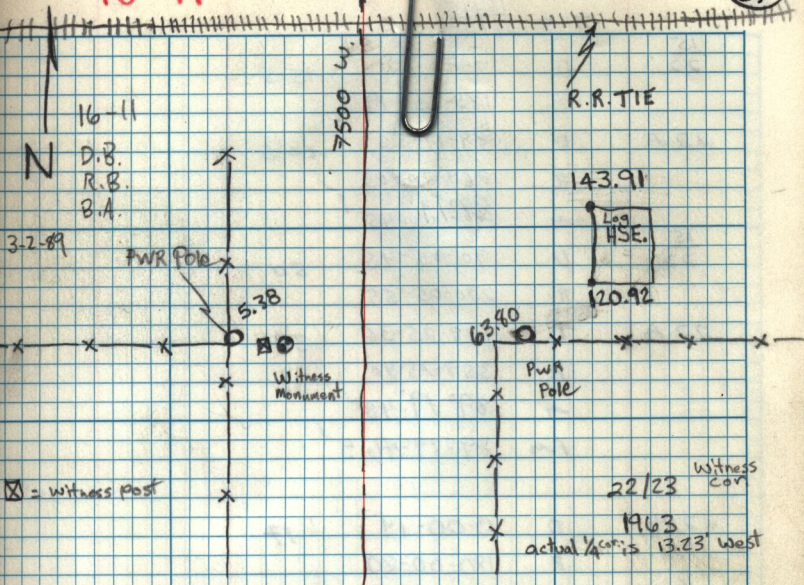

10/11	0-00-15	
15/14	180-00-19	17
15/14	180-10-47	47
22/23	00-10-47	
	30	
	90-05-43	43.5
	270-05-44	
	270-16-08	10
	90-16-12	
	26.5	
	180-10-28.25	