


3-2-89

2 Brass Caps FND 2.29' Apart
East B. cap is 1982 West Cap is 1963

(67)

16/15
T.6N. R.3 W.

All Ties to
East Cap - 1982

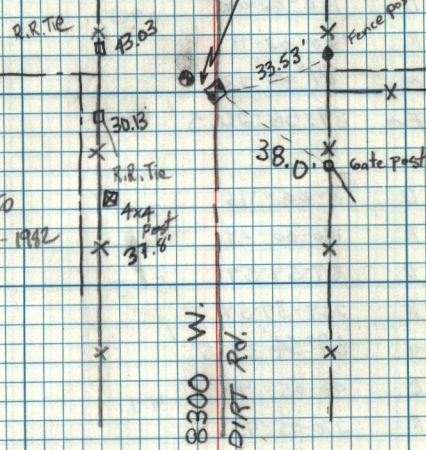

18-9