


3-29-89


D. Butters
P. Balten
B. Knaue

T. 6N.
R. 4W R. 3W

24 | 19 1982

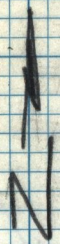


Toe of Hill

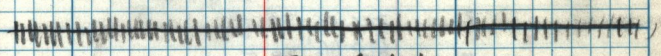

Toe of Hill

Top of Hill

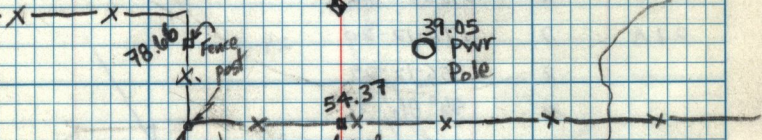

78.66
Fence
x Post

39.05
Pwr Pole

54.37
Fence Post

Slope Dist.
93.64


R.R. RAW
Fence

Nail & washer
in Fence Posts
& Pwr. Pole

200'

shore line

Great Salt Lake

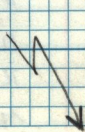

08 50 40 901